

LEGEND:


- ▲ SET TAG L.S. XXXX ON TOP OF CON. CURB AT THE PROLONGATION OF SIDE LOT LINES FOR FRONT CORNERS, ALSO FOR CURB RETURNS, E.C.'S AND B.C.'S PER RIVERSIDE COUNTY STANDARD.
- INDICATES SET 1" I.P., W/PLASTIC PLUG, L.S. XXXX, FLUSH, UNLESS OTHERWISE NOTED, PER RIVERSIDE COUNTY STANDARD.

COMPANY TITLE BLOCK
 COMPANY CONTACT INFORMATION

DATE: _____
DRAWN BY: _____
SHEET OF _____

CENTERLINE TIES
 STREET NAME(S)
 TR. XXXXX, MBXX /XXX

GRAPHIC SCALE

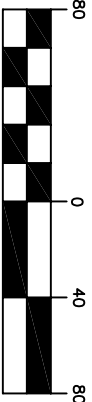

(IN FEET)
 1 inch = 80 ft.